




USS SALEM CA 139
THREE QUARTER BOW
QUINCY BAY
9 MAY 1949

~~CONFIDENTIAL~~

SELECTED
RECORD PLAN

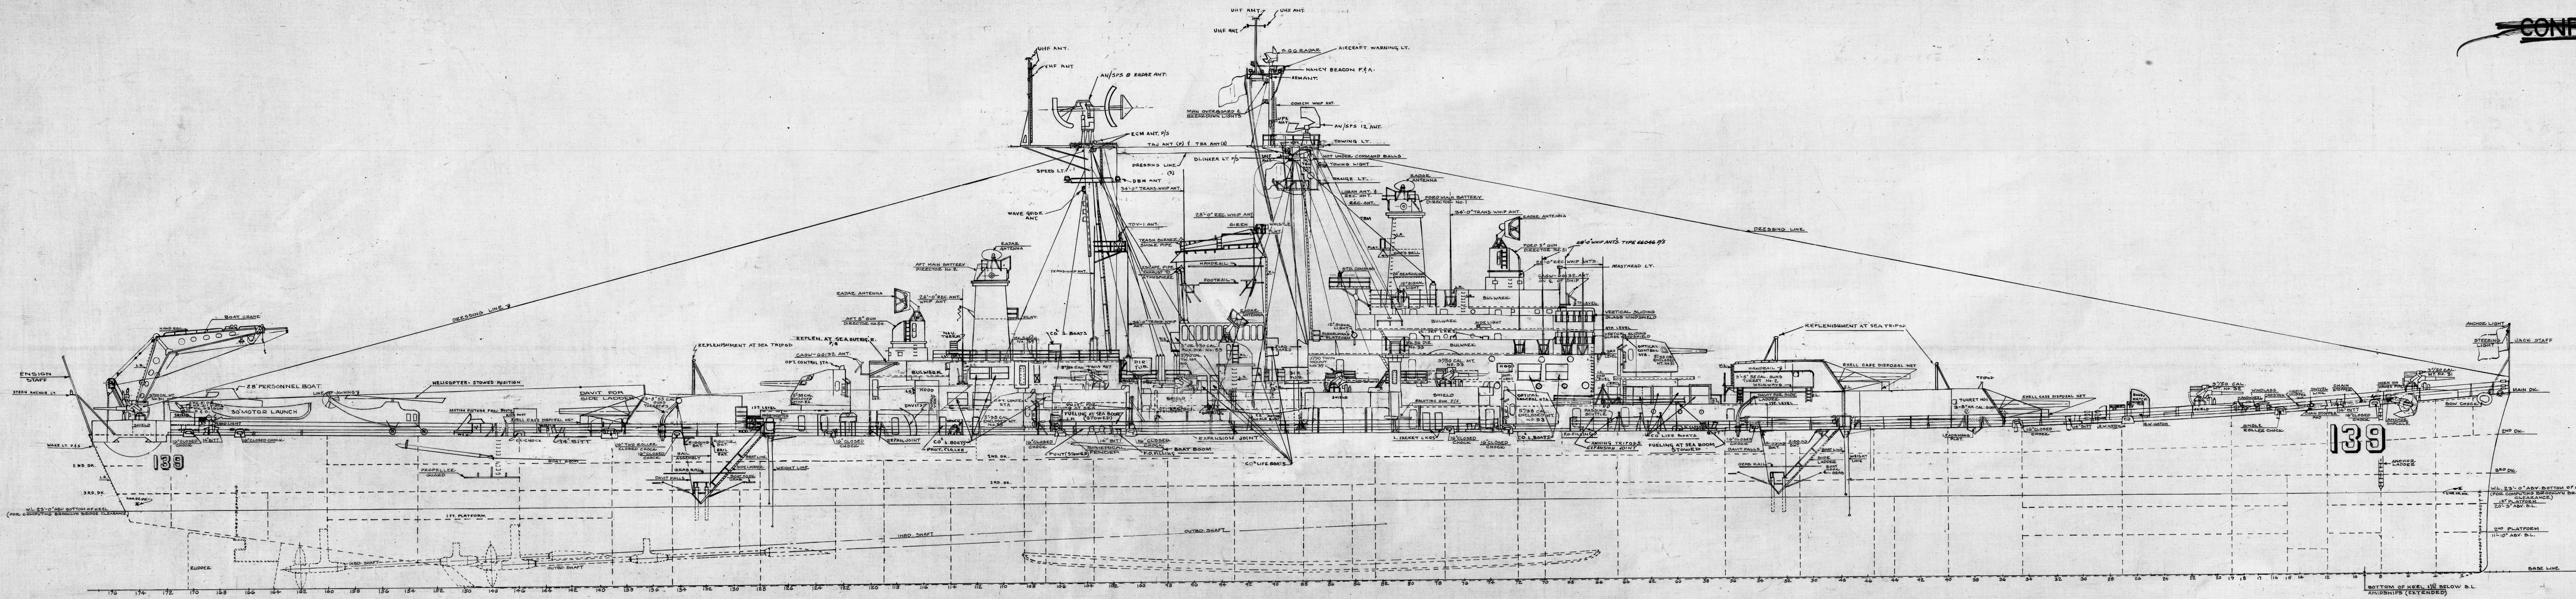


OUTBOARD PROFILE

U.S.S. SALEM CA 139
BUREAU OF SHIPS NO. CA 139-50103-531700
SCALE 1/8" = 1 FOOT

~~CONFIDENTIAL~~

SELECTED
RECORD PLAN

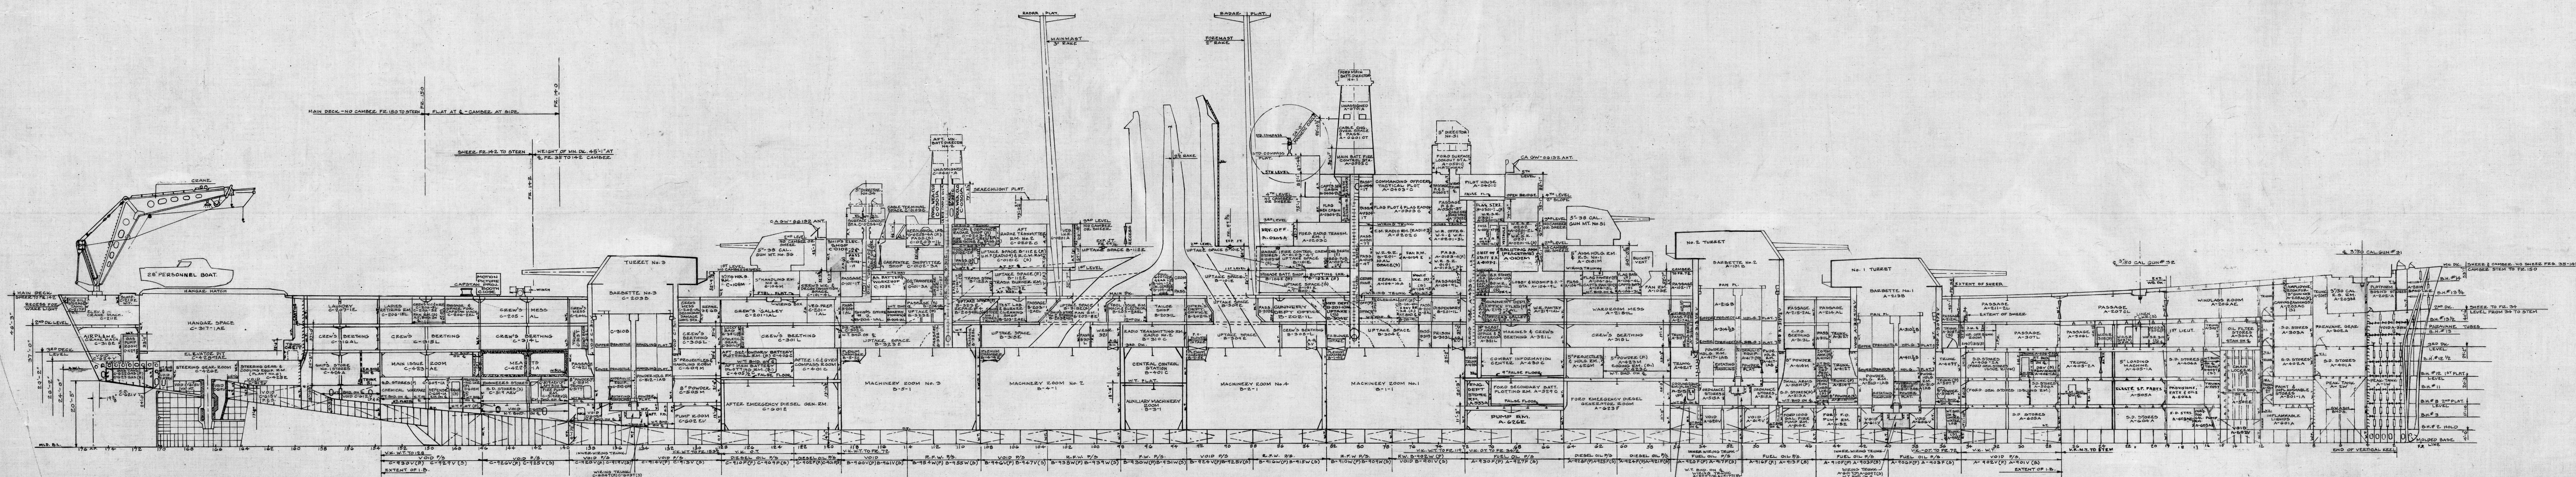


INBOARD PROFILE

U.S.S. SALEM CA 139
BUREAU OF SHIPS NO. CA 139-50103-531700
SCALE 1/8" = 1 FOOT


~~CONFIDENTIAL~~

SELECTED
RECORD PLAN

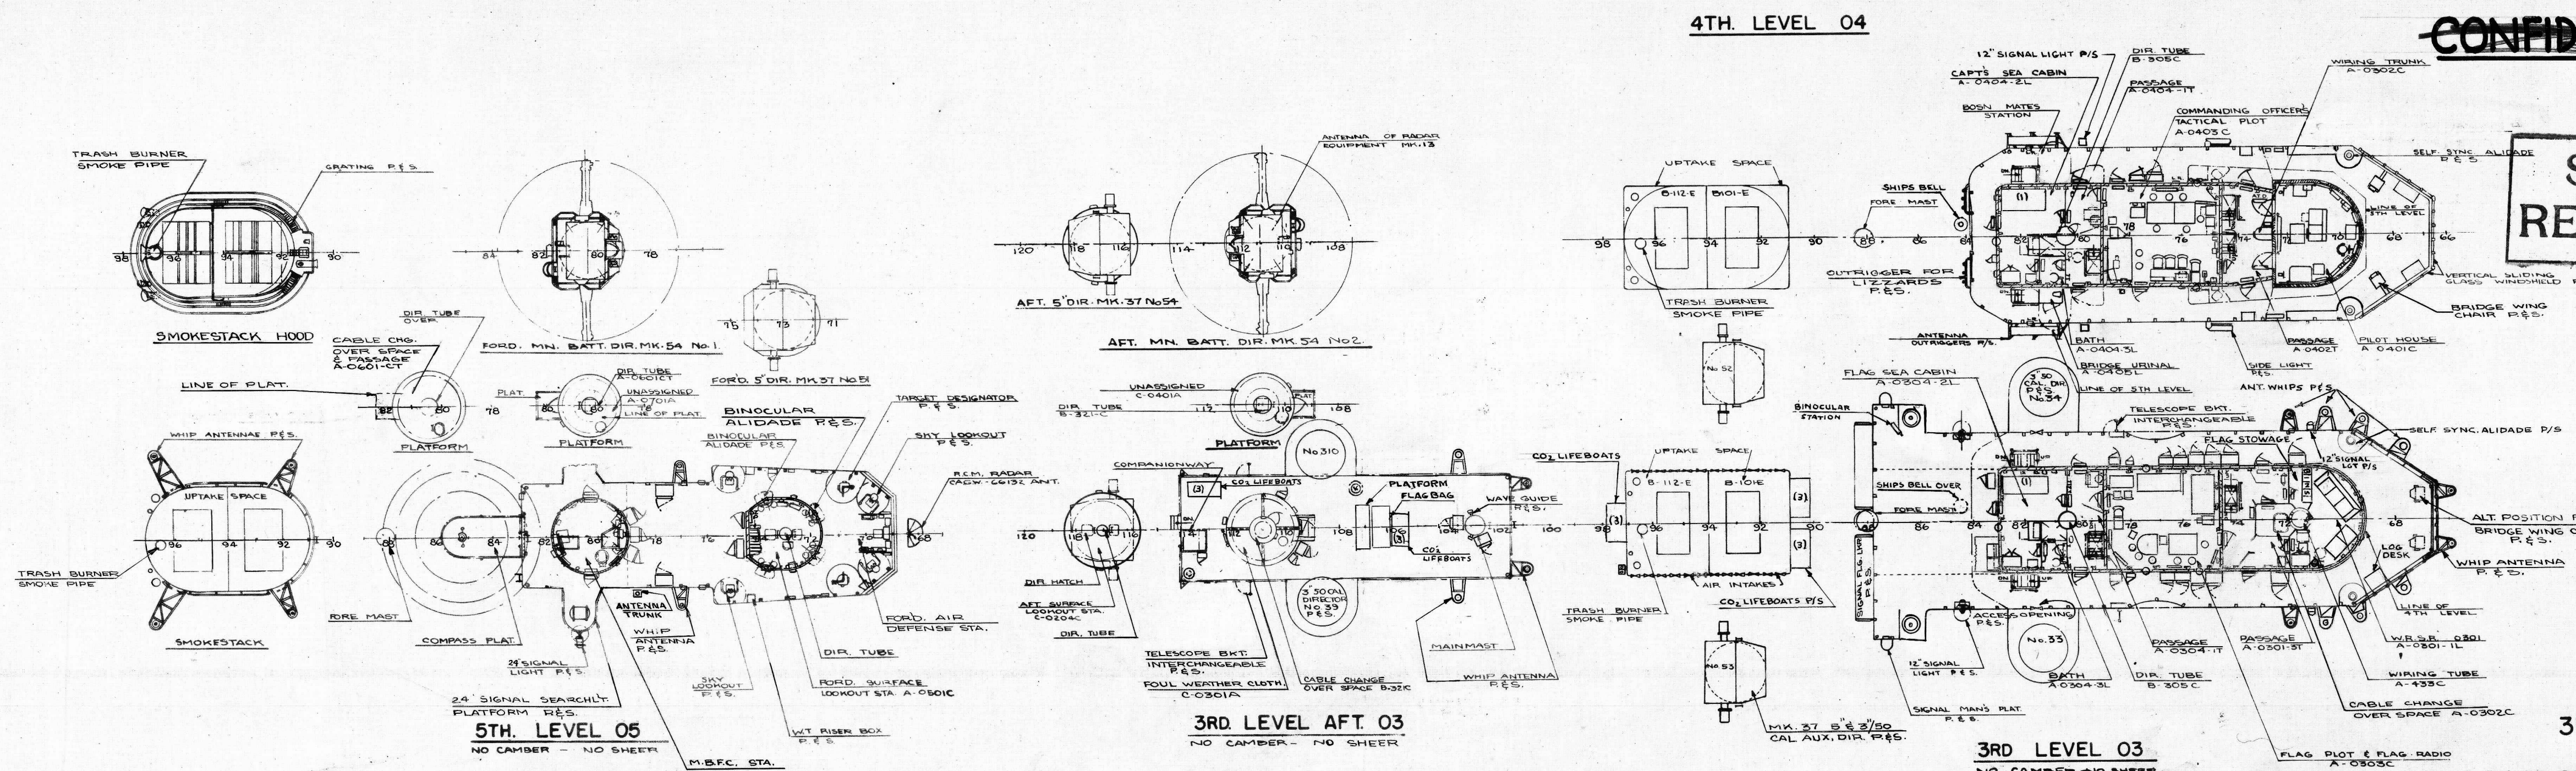

~~CONFIDENTIAL~~

SELECTED
RECORD PLAN

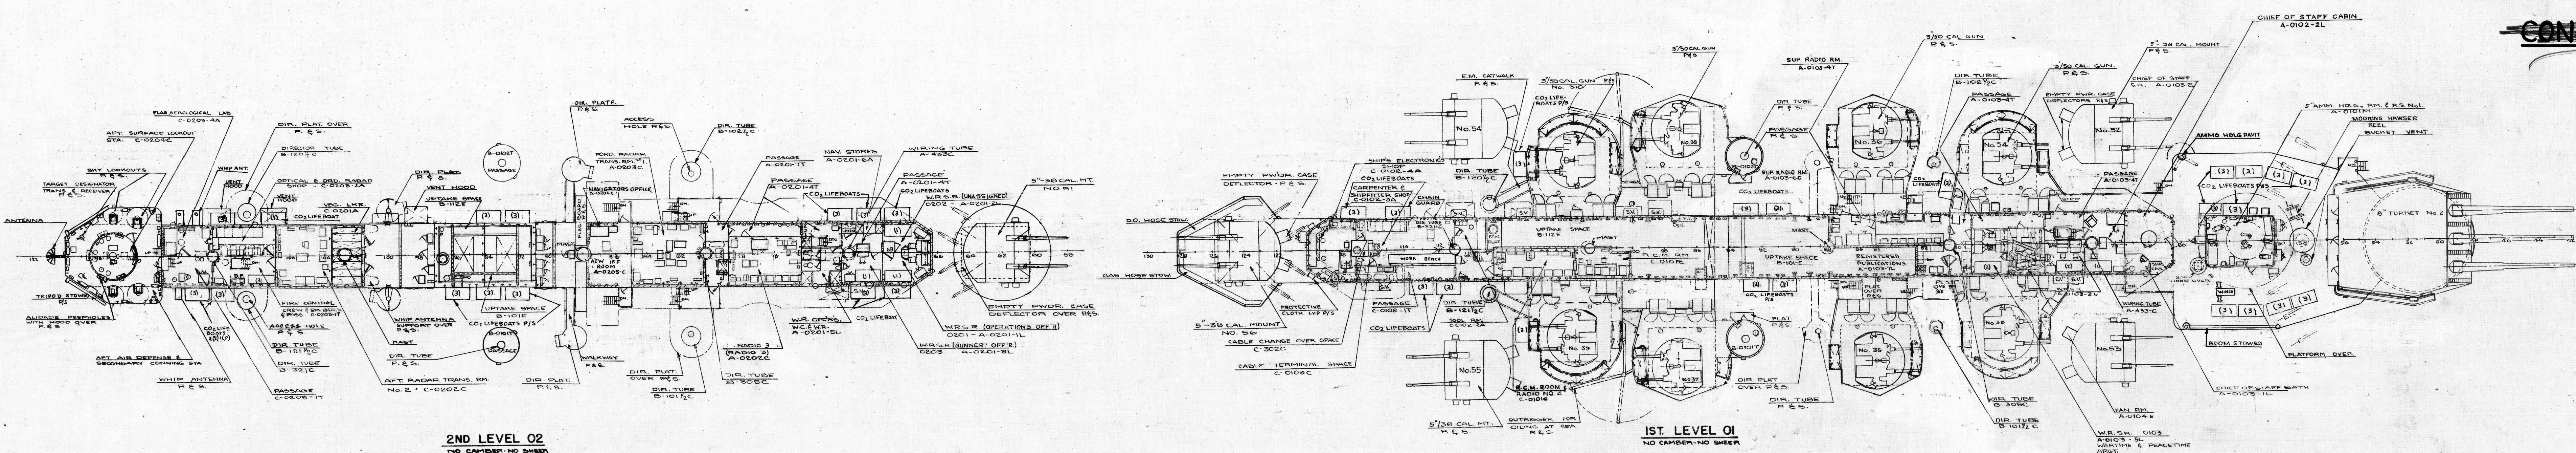

~~CONFIDENTIAL~~

SELECTED
RECORD PLAN

